RFP-MCC-2101

Assessment and Design of Springhill Box Culverts

Addendum #1


The following modifications reflect a change to the RFP document.


Section 2 – Scope of Work

1. Background

Available drawing of the services at Coal Mine Brook is attached for information, Dwg No. 601 R2 - Springhill Watermain Replacement, McGee Street - Plan & Profile STA 0+000 to 0+350 - Record Dwg - Feb. 15, 2009.

End of Addendum #1

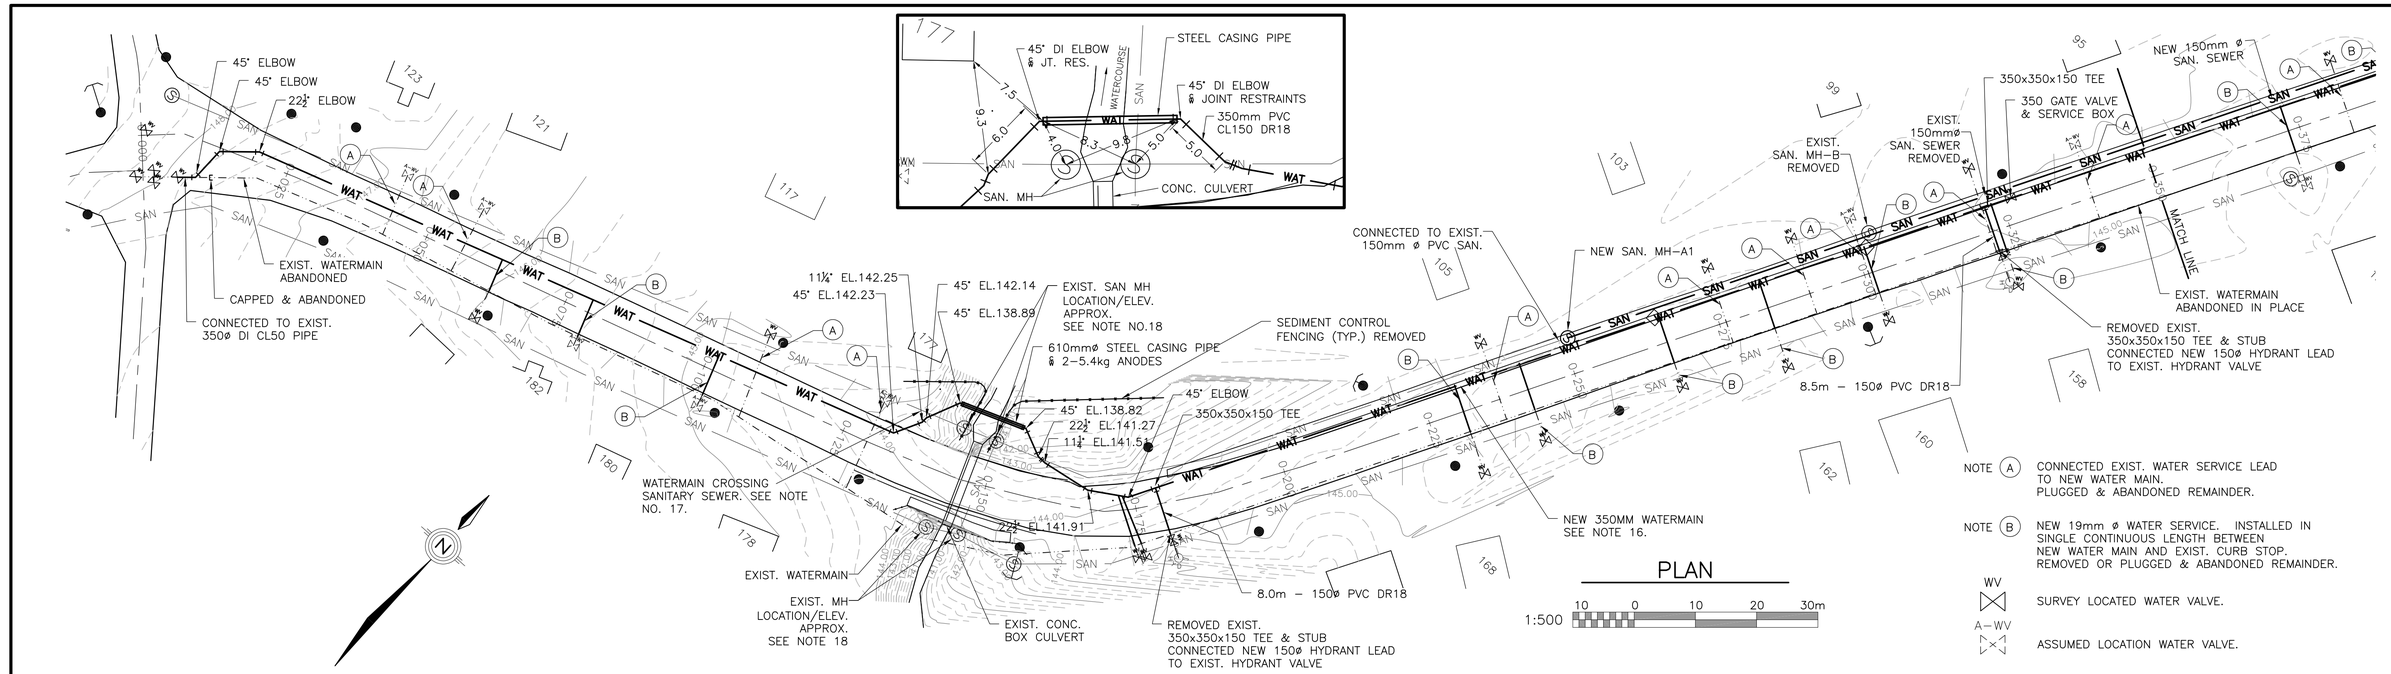

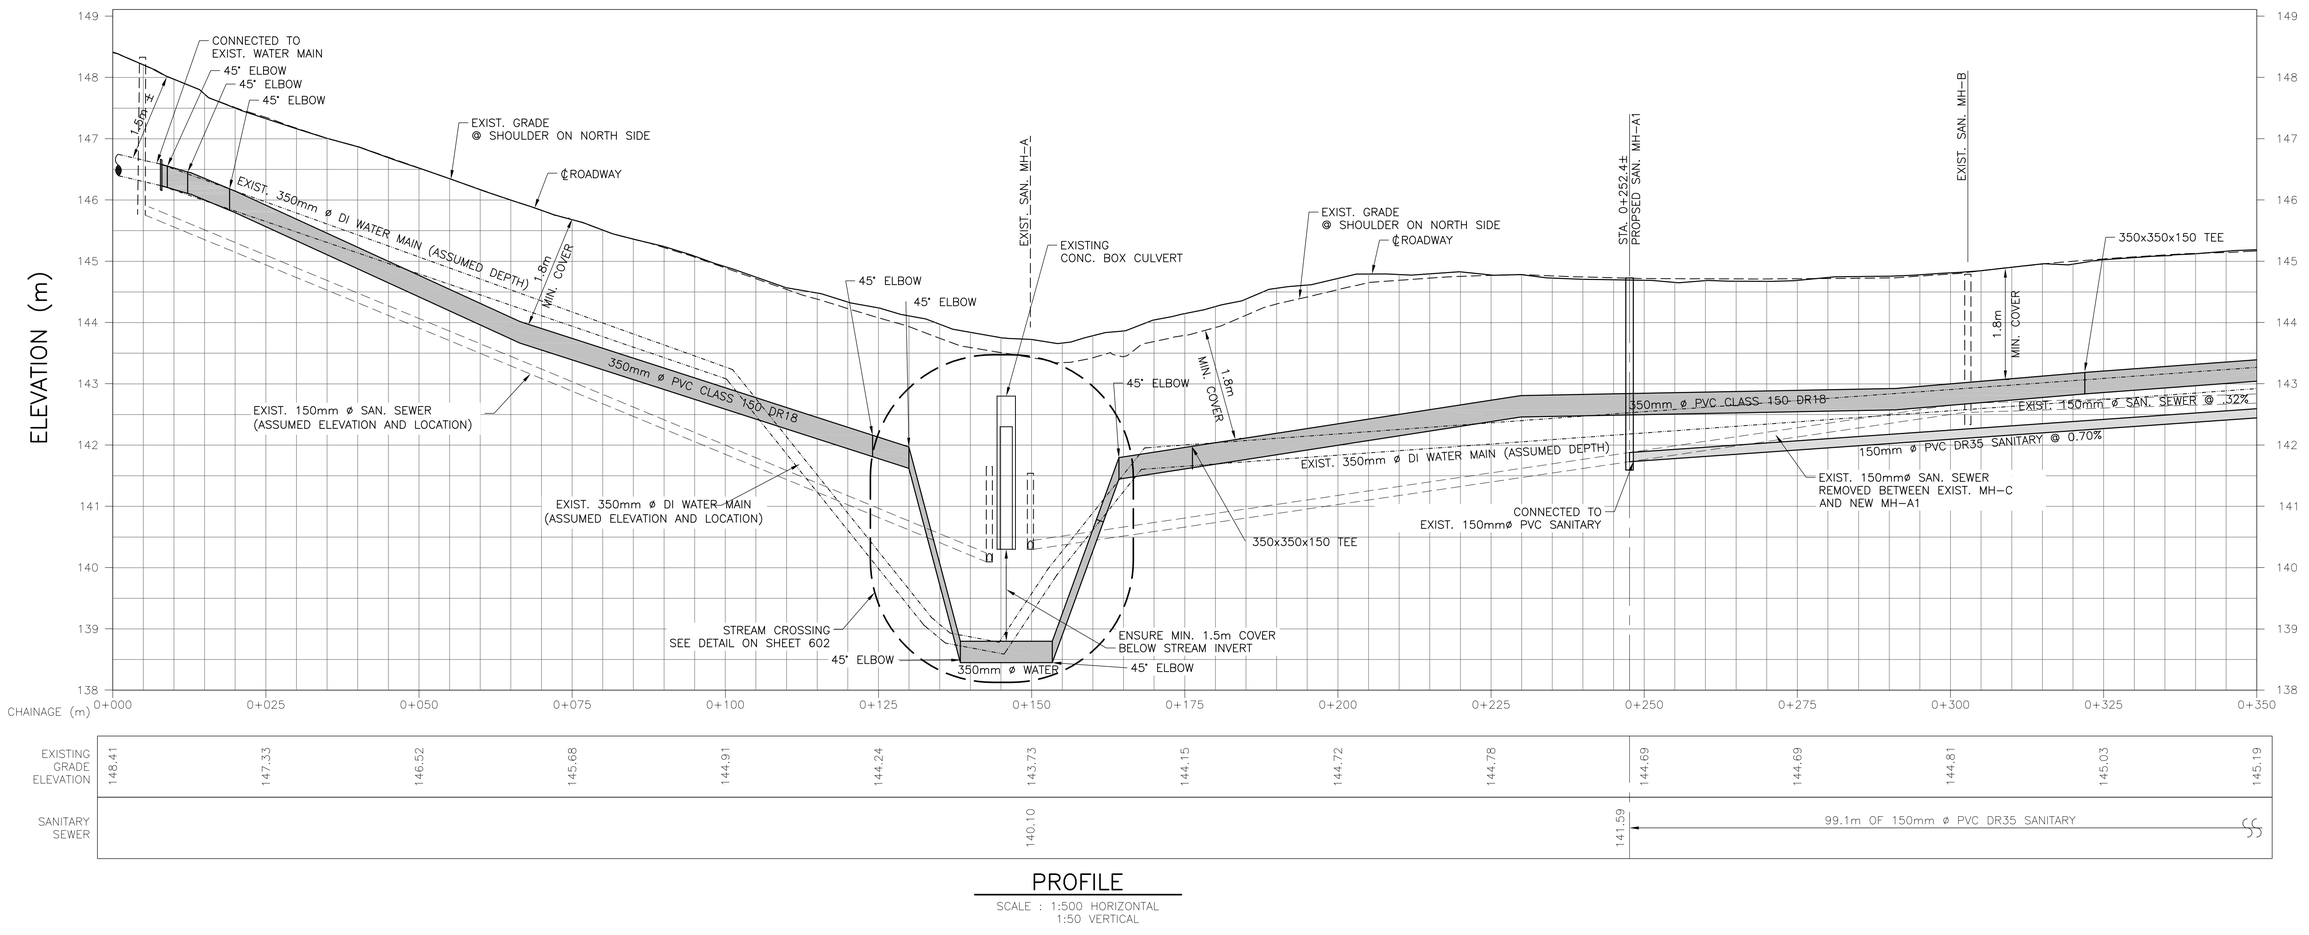

PROFILE

SCALE : 1:500 HORIZONTAL
1:50 VERTICAL

AMEC Americas Limited

Rev	Remarks	Date
2	RECORD DRAWING	15/02/09
1	ISSUED FOR CONSTRUCTION	10/19/07
0	ISSUED FOR TENDER	08/09/07

Project Title: WATERMAIN REPLACEMENT
McGEE STREET
SPRINGHILL, N.S.

Drawing Title: PLAN & PROFILE
STA. 0+000 TO 0+350

Designed By: GHM	Project No.: 156151	Revision: 2	
Drawn By: VAA/JGN	Date: 2007.08.03	Scale: AS NOTED	
Checked By: GHM	Drawing No.: 601		
Approved by: GHM			

Plot Date: Feb. 27,2009–11:02am john.eason
File Name: 156151dwg601and602–RECORD.dwg